



100 Series MCC


This information is provided in good faith to describe assets available for sale “as is, where is, without warranty.” The information is believed to be accurate; however, verification of the details and determination of suitability for use are the responsibility of the buyer. Availability is subject to prior sale.



More equipment photographs are available on subsequent pages. To inquire about equipment pricing and specifications, please contact:

Chris Mimes
Asset Recovery Manager
chris.mimes@royomartin.com
(318) 561-6016 (office)
(318) 446-1132 (cell)



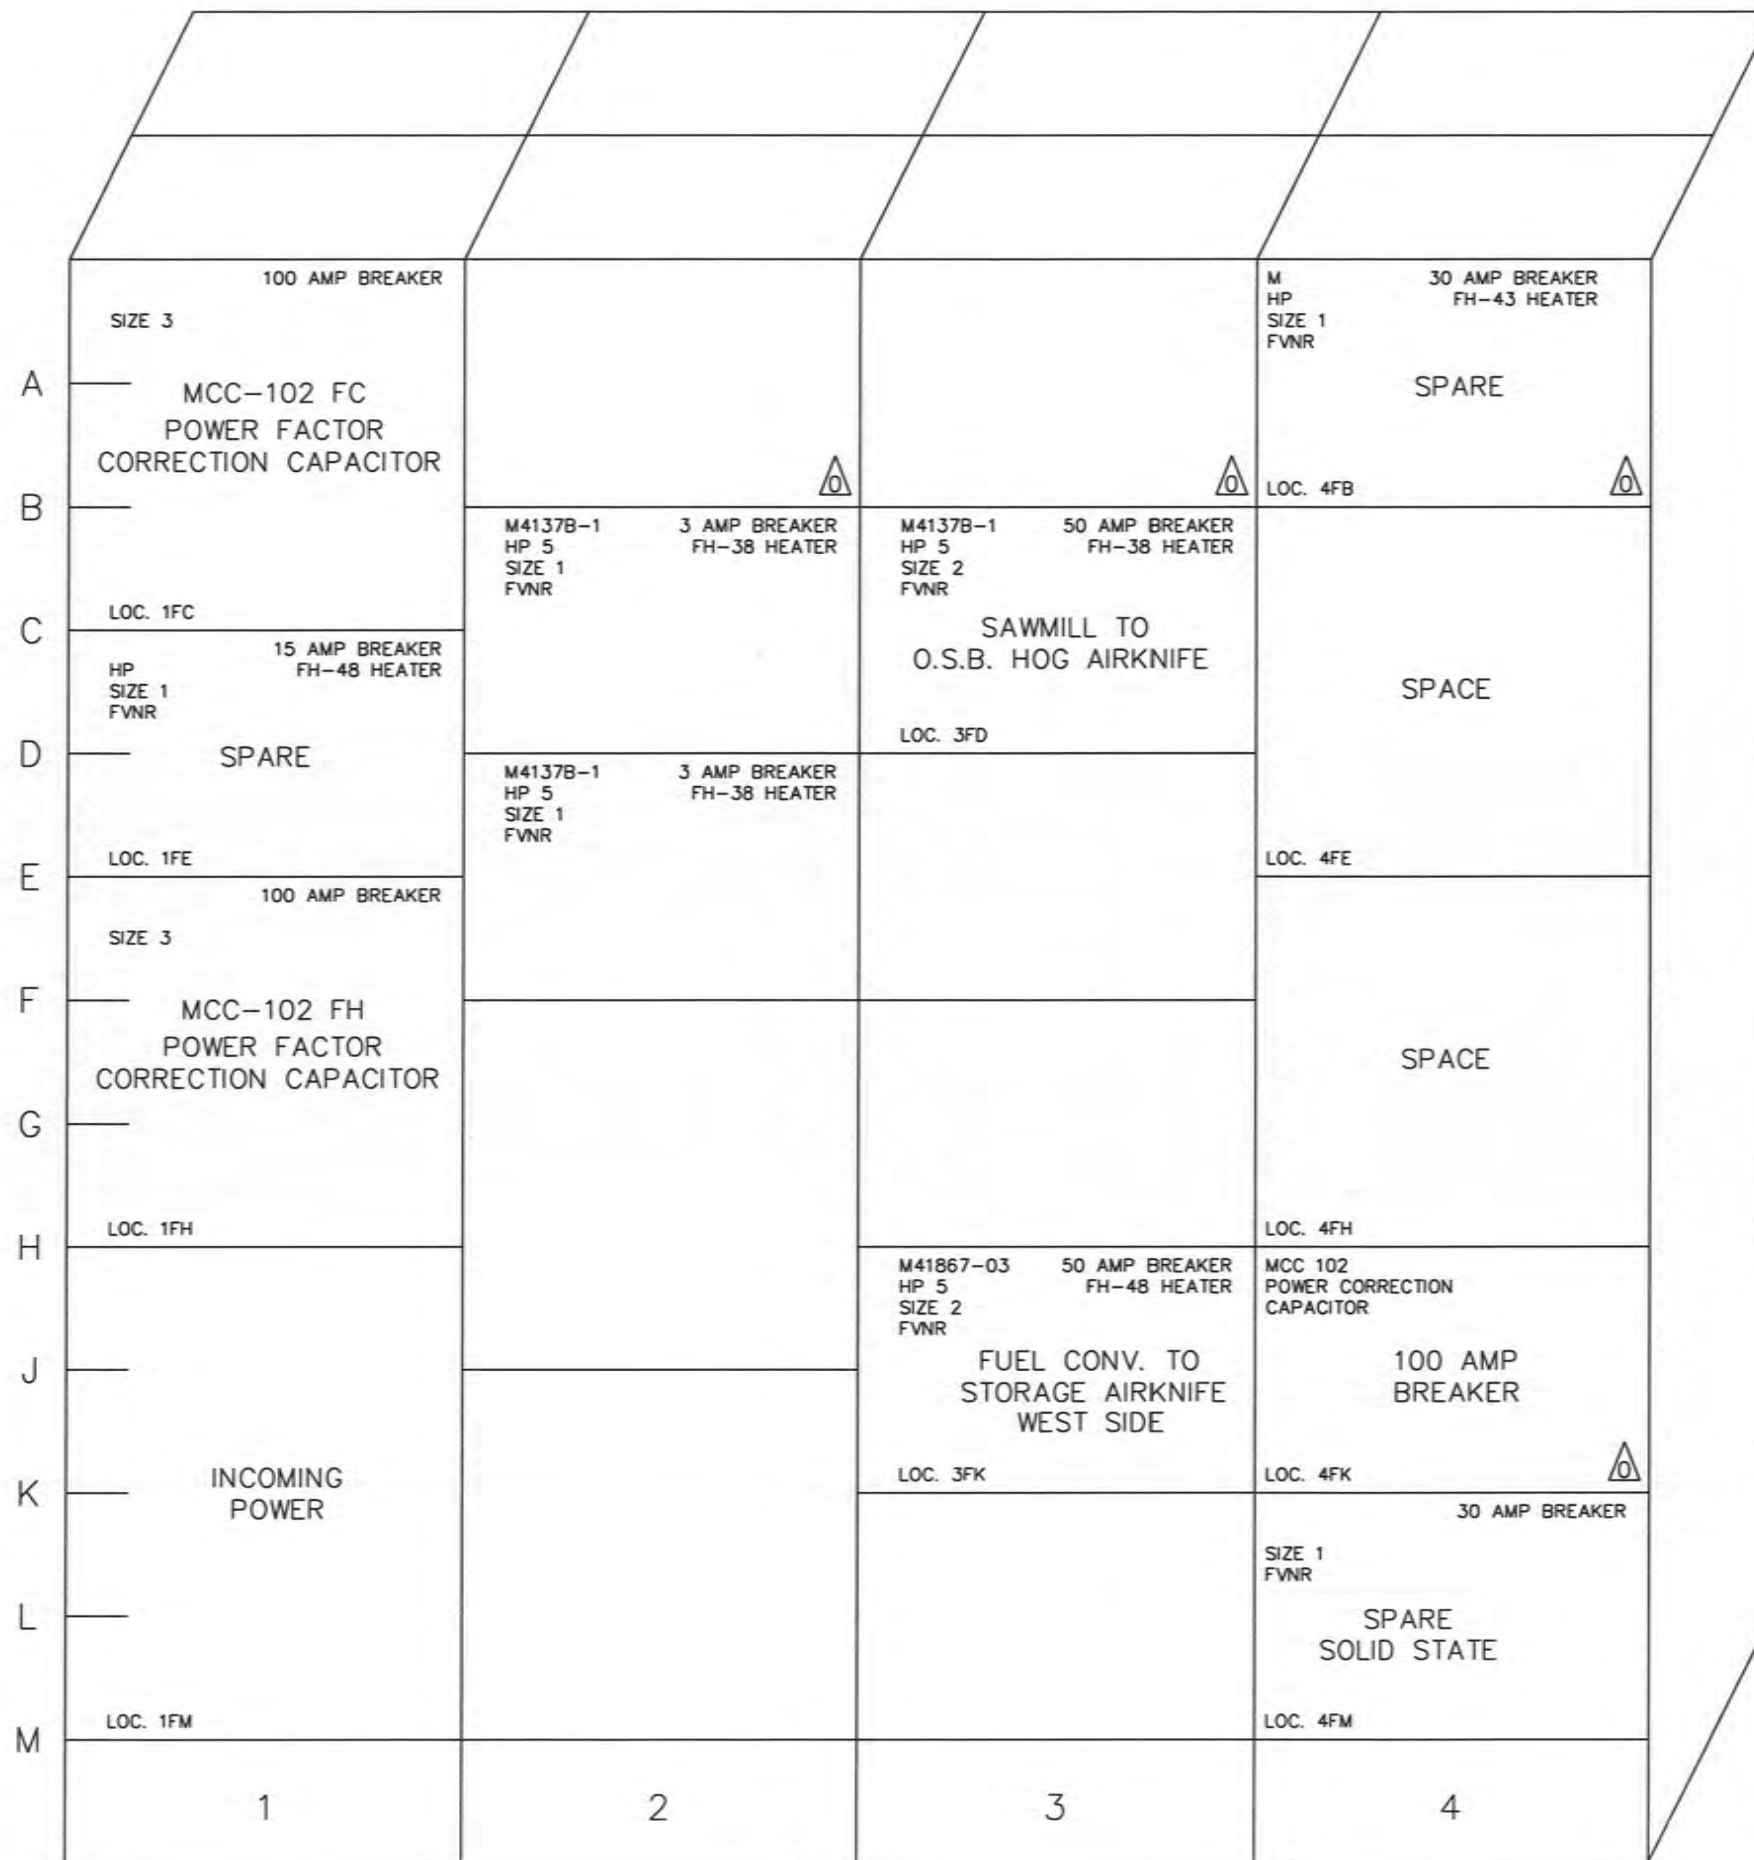

Westinghouse
800 AMP - H buss
800 AMP section 1
600 AMP section 2,3,& 4


(AS BUILT)

TITLE:	MCC LAYOUT MCC 102 FRONT ELECTRICAL ROOM #1A
REV.	DRAWING NUMBER
0	1-13.4

PLANT NAME: **ROM**
MARTCO
PARTNERSHIP
LEMOYEN, LOUISIANA


NO.	REVISION
G	BASIC REVISIONS W.B.H. 09-18-96
H	REVISED ALL LOCATIONS W.B.H. 02-04-97
J	As Built - 9/15/10

0	REVISED PER	BY P.J.D. ON 07/17/01
DR. BY	DATE:	
Weldon Helbert	March 16, 1991	

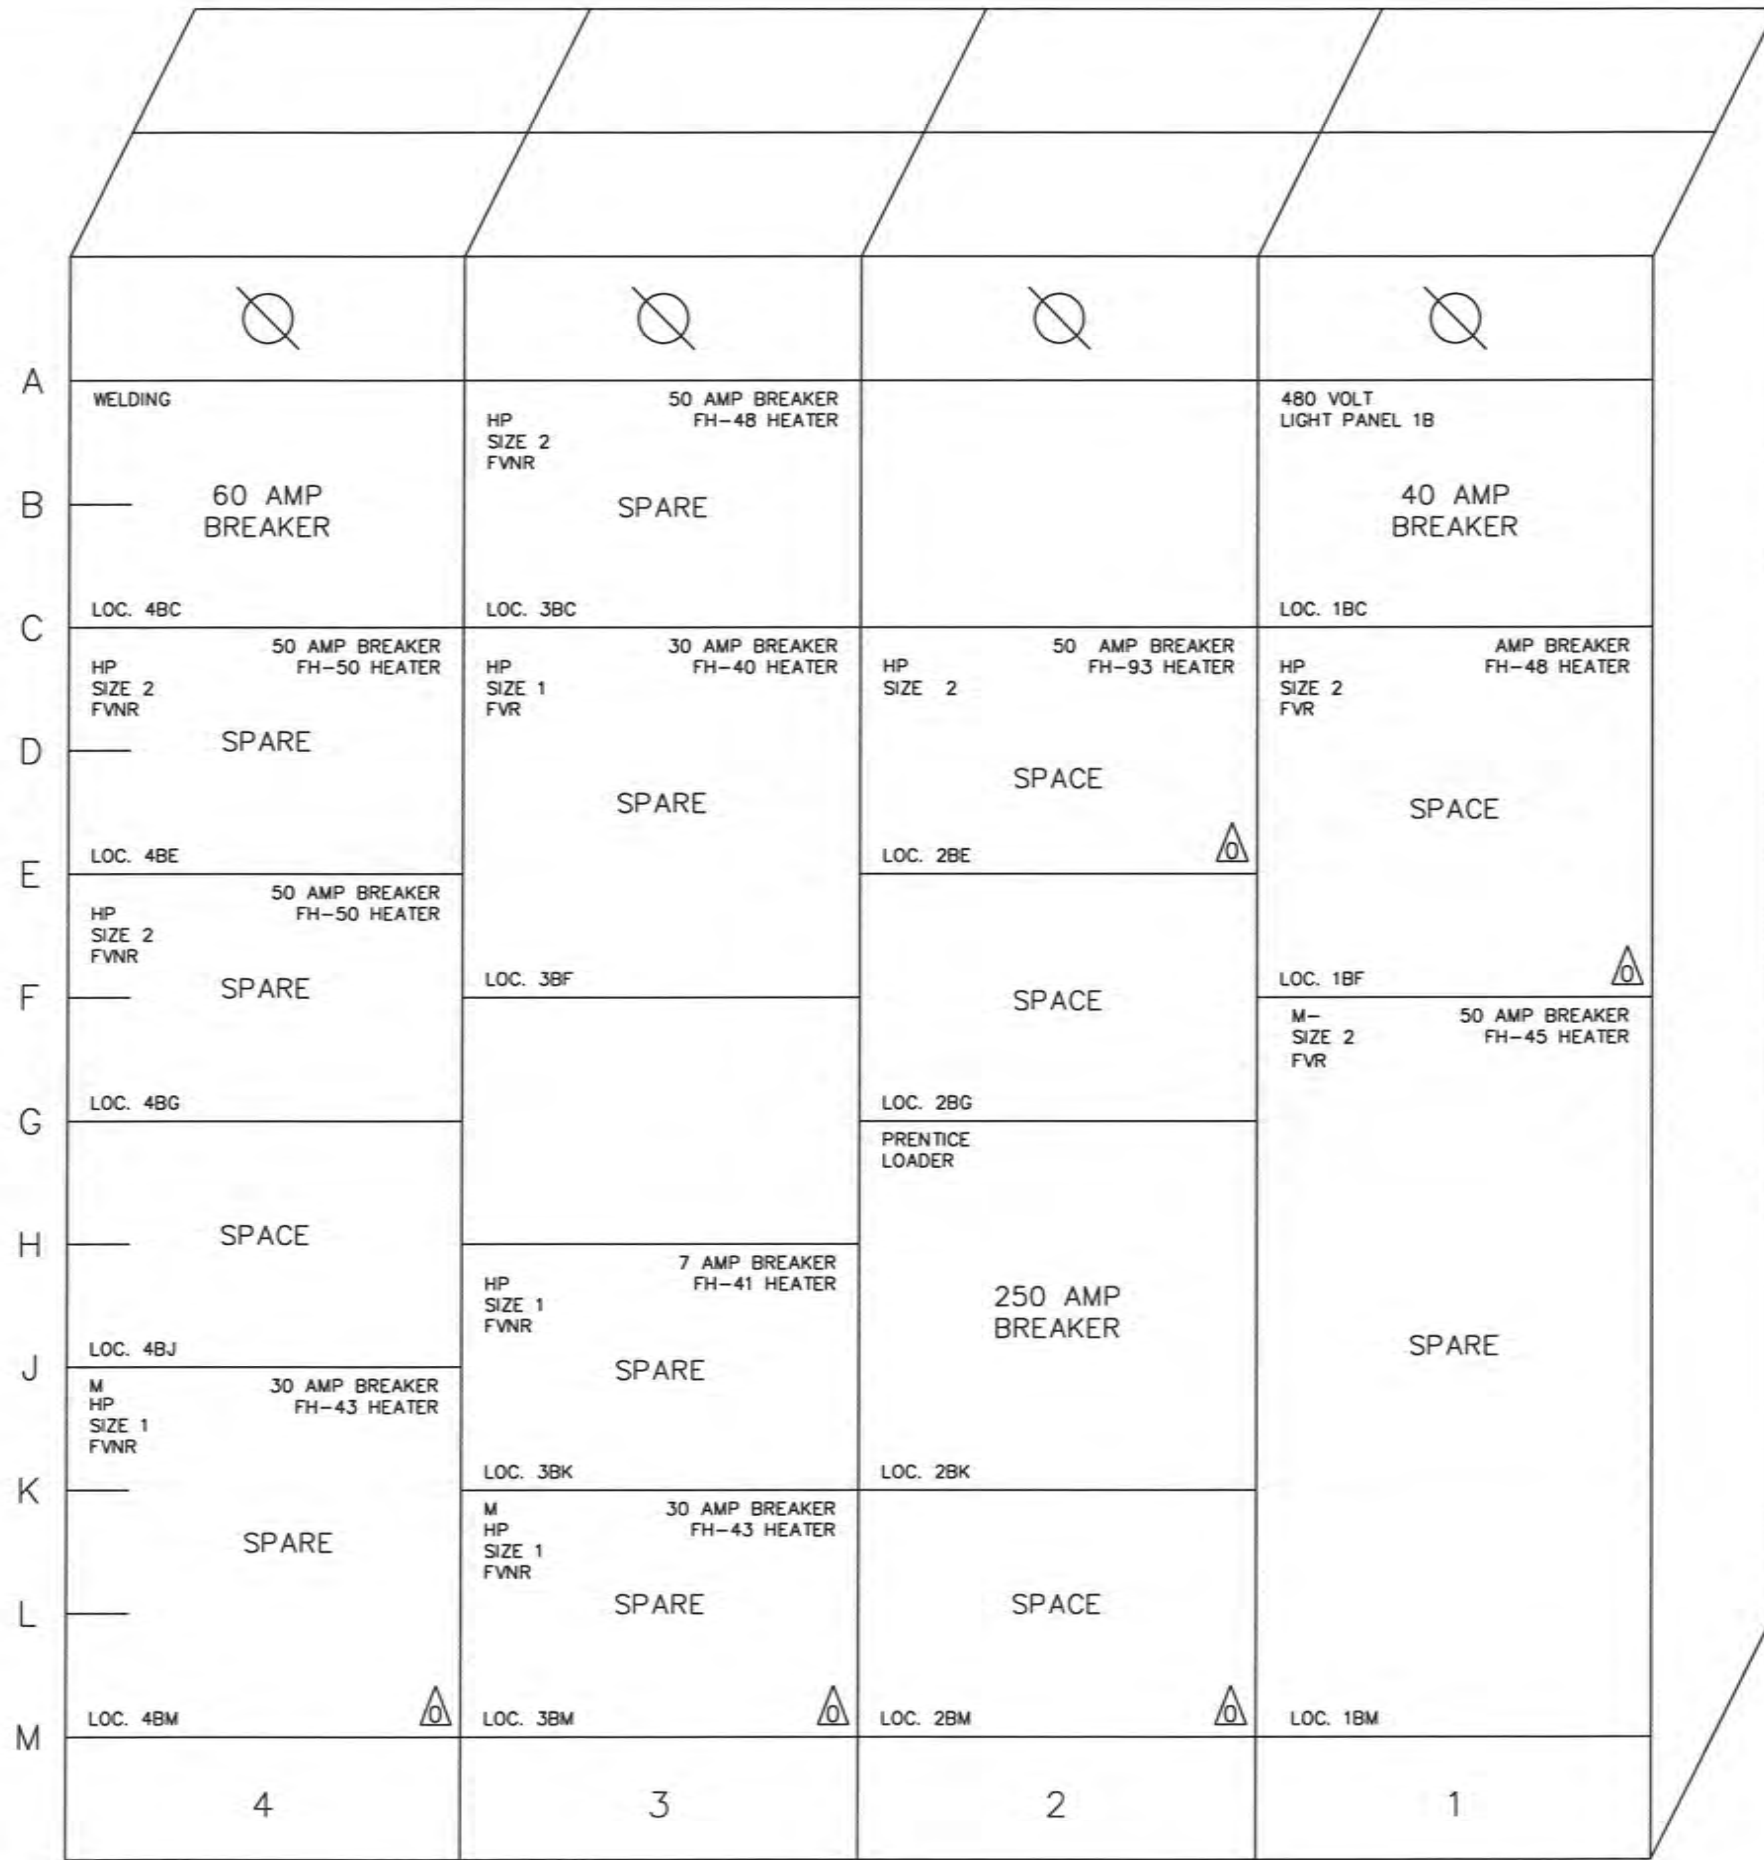

(AS BUILT)

TITLE: MCC LAYOUT MCC 102 BACK ELECTRICAL ROOM #1A	PLANT NAME: MARTCO PARTNERSHIP LEMOYEN, LOUISIANA	NO. G	REVISION	REVISOR: P.J.D. ON 07/17/01
REV. 0	DRAWING NUMBER 1-13.5	H	BASIC REVISIONS W.B.H. 09-18-96	
		J	REVISED ALL LOCATIONS W.B.H. 02-05-97	
			As built 9-15-10	
			DR. BY Weldon Hebert	DATE: March 16, 1991

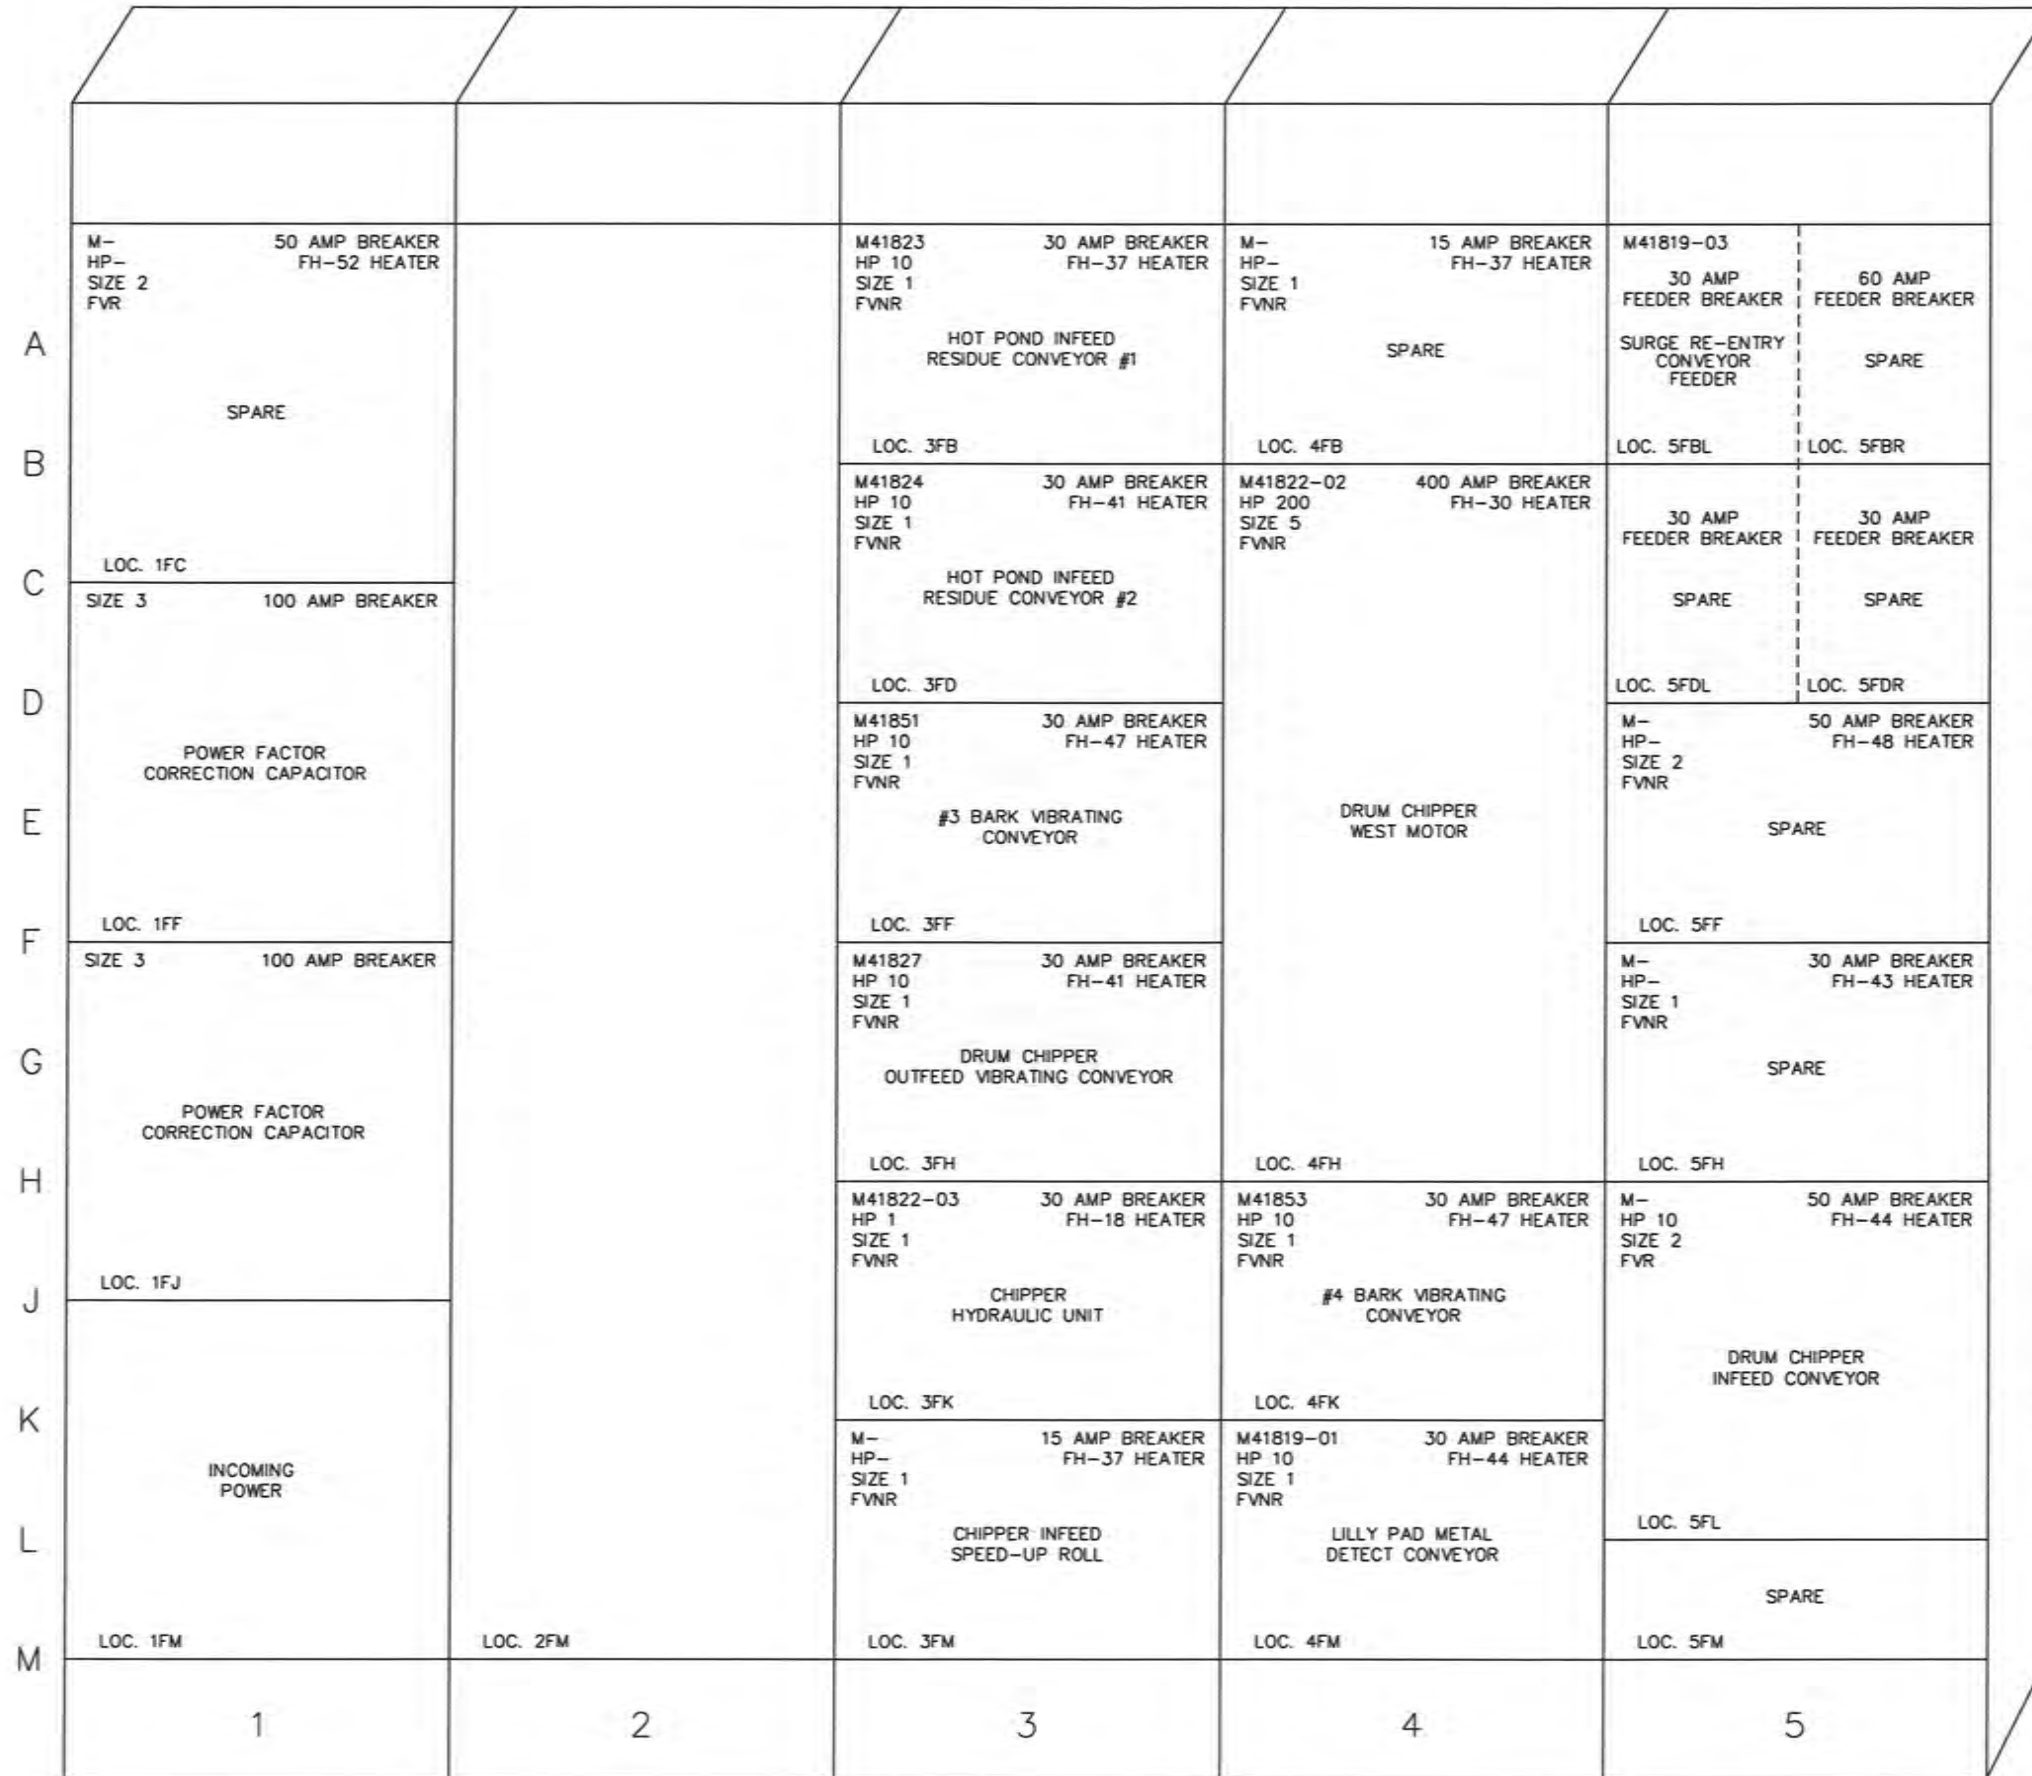

800 AMP H-Buss
Section 1, 800 AMP
Section 2-5, 600 AMP

TITLE: MCC LAYOUT MCC 106 FRONT ONLY ELECTRICAL ROOM #1A		NO. B		REVISION	
REV. D	DRAWING NUMBER 1-13.42	C	REVISD ALL LOCATIONS W.B.H. 02-25-97 Rec. on Loc. 1FC,3FD,3FM,4FH,5FH,5FL W.B.H. 03-19-99		E
PLANT NAME: MARTCO PARTNERSHIP LEMOYEN, LOUISIANA		NO. C		REVISION	
DATE: Sept. 24, 1996		NO. E		REVISION	
DR. BY: Weldon Hebert		NO. E		REVISION	